

091594

FROM: Mining Recorder at WHITEHORSE

TO: Regional Manager, Mineral Rights at Whitehorse, Y.T.



FOR ACTION ARE:

- ☐ NEW APPL'N for PLACER LEASE to PROSPECT: Name:
- ☐ RENEWAL APPL'N PLACER LEASE to PROSPECT: Name:
- ☐ AFFIDAVIT of EXPENDITURE on PLACER LEASE. Name:
- ☐ SECURITY DEPOSIT
- ☐ FINANCIAL ABILITY
- ☐ ASSIGNMENT of PLACER LEASE No.
From: To:

Lease No.

Lease No.

- ☐ GROUPING APPL'N UNDER SEC.52(2) PLACER MINING ACT.
Owner:

- ☒ DIAMOND DRILL LOGS: (for your information only)

Claims: NOLF 1-6

Claim sheet no: 105-D-11

- ☐ QUARTZ ASSESSMENT REPORT:
Claims:

Claim sheet no:

Type of report:

Submitted by:

Cls. work performed on

\$ Req. for ren. application

Signature [Signature]

REPLY ACTION.


Date Ret.

CC GEOLOGY SECTION



DEPARTMENT OF INDIAN AFFAIRS AND NORTHERN DEVELOPMENT
YUKON QUARTZ MINING ACT
FORM "C" - APPLICATION FOR A CERTIFICATE OF WORK

091594

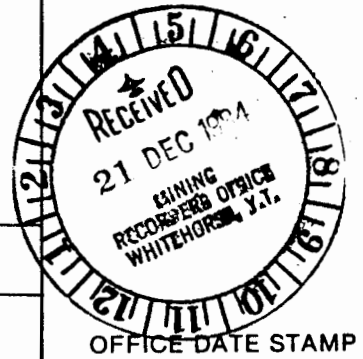

(This form required in duplicate with sketch showing location of work.)

I (Name) <u>STEVE. J. TAKACS.</u>	Occupation
(Postal Address) <u>30-10 AVE. WHITEHORSE. Y. T.</u>	

MAKE OATH AND SAY, THAT:

1. I am the owner, or agent of the owner, of the mineral claim(s) to which reference is made herein.

2. I have done, or caused to be done, work on the following mineral claim(s):

(Here list claims on which work was actually done by number and name)

WOLF # 1 Y-67800

" 2 Y-67801

" 6 Y-67806

situated at FRANKLIN LAKE AREA. Claim Sheet No. 105-D-11.

in the WHITEHORSE. Mining District, to the value of at least \$ 900

dollars, since the 8 DEC 1983 day of DEC. 19 83

to represent the following mineral claims under the authority of Grouping Certificate No. 9410 Q

(Here list claims to be renewed in numerical order, by grant number and claim name, showing renewal period requested).

WOLF # 1 Y-67800

2 Y-67801

3 Y-67802

4 Y-67803

5 Y-67804

6 Y-67805

1 yr. 8/12/84

3. The following is a detailed statement of such work: (Set out full particulars of the work done indicating dates work commenced and ended in the twelve months in which such work is required to be done as shown by Section 53.)

D.D.H. # 14 28FT. CASING DRILLED. NO BED ROCK REACHED.

D.D.H. # 15 18FT " " CORED 32 FT 6 in

D.D.H. # 16 26FT " " " 15 FT.

ALSO CUT OUT TRAIL. DRILLING WATER SUPPLYED BY
200 GALL. TANKER TRUCK
TO D.D.H. 14.

Sworn before me at WHITEHORSE

this 21 day of DEC. 19 84

Notary Public

Owner or Authorized Agent



091594

DRILL SAMPLING REPORT

DATE: 14 OCT 1984 TIME: 0930HRS to 2300HRS DRILL HOLE NO. 14

DRILLER: STEVE J. TAKACS. DIAMETER OF HOLE: 2" CASSING

HELPER: - DEPTH OF CASING: 28 FT.

DEPTH OF OVERBURDEN: 28 FT. DRILLING TIME: 1400HRS to 2100HRS.

DEPTH TO BEDROCK: UNKNOWN. DRILL PREPARATION: 13 OCT. 1900 to 2200HRS

TOTAL FOOTAGE DRILLED: 28 FT CASSING DOWNTIME: NON.

FOOTAGE	SAMPLE NUMBER	REMARKS
28 FT.		D.D.H. 90°

GENERAL COMMENTS:

TRY TO RECOVER BED ROCK FROM TRENCH.

TO DRILL HIGH. R-16 ANOMALY DONE BY

S. PASANIK. GED PHENS

AL CORE STORED AT. 30-10 AVE WHSEY.

CONCENTRATOR REMARKS:

SIGNED	(DRILLER) <u>C. J. Takacs</u>
	(CO-REP)



~~DRILL~~ DRILL SAMPLING REPORT

DATE: 22+23 SEPT 1984 TIME: 1000HRS 22 SEPT.

DRILL HOLE NO. 15

DRILLER: STEVE J. TAKACS.

DIAMETER OF HOLE: 2" CASING 1" CORE

HELPER: -

DEPTH OF CASING: 18 FT.

DEPTH OF OVERBURDEN: 16 FT

DRILLING TIME: 12 HRS.

DEPTH TO BEDROCK: 16 to 18 FT

DRILL PREPARATION: 4 HRS

TOTAL FOOTAGE DRILLED: 32 FT 6 in

DOWNTIME: NONE

FOOTAGE	SAMPLE NUMBER	REMARKS
32 F		CHERTY QUARCITE BADLY DECOMPOSED AND BROCKEN.

GENERAL COMMENTS:

STOPPED AT 32 FT 6 in DUE TO CONSTAN CAVIN
THE HOLE.

HOLE DRILLED 65° ENGEL. BEARING N 15° E.


AL CORE STORED AT 10-30 AVE. WHSE. Y.T. (ON THE PORCH)

CONCENTRATOR REMARKS:

SIGNED

(DRILLER)

(CO-REP)

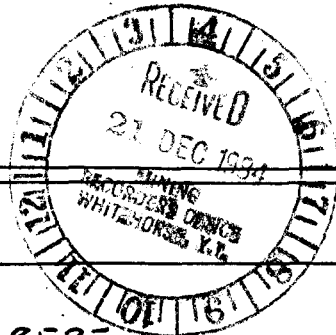

~~DRILL~~ DRILL SAMPLING REPORT

DATE: 29 + 30 SEPT 84 TIME: 1400 HRS. 29 SEPT DRILL HOLE NO. 16

DRILLER: STEVE, J. TAKACS. DIAMETER OF HOLE: 2" CASING.

HELPER: ✓ DEPTH OF CASING: 26 FT

DEPTH OF OVERBURDEN: 24 FT DRILLING TIME: 12 HRS. APP.

DEPTH TO BEDROCK: 26 START CORE DRILL PREPARATION: 4 HRS.

TOTAL FOOTAGE DRILLED: 15 FT CORE DOWNTIME: N/A.

FOOTAGE	SAMPLE NUMBER	REMARKS
15. FT		DECOMPOSED. CHERT & VARCITE
		AND META DIORITE.?

GENERAL COMMENTS:

D.D. HOLE # 16 DRILLED ~~15 FT~~ 65° BEDRING N 35° W.


AL CORE STORED, RT 30-10 AVE. WASE Y.T.

CONCENTRATOR REMARKS:

SIGNED	(DRILLER) <u>CS</u>
	(CO-REP)


105-D-11 WHITEHORSE. MINERAL CLAIM WOLF 1 to 6.

16 Oct 1986

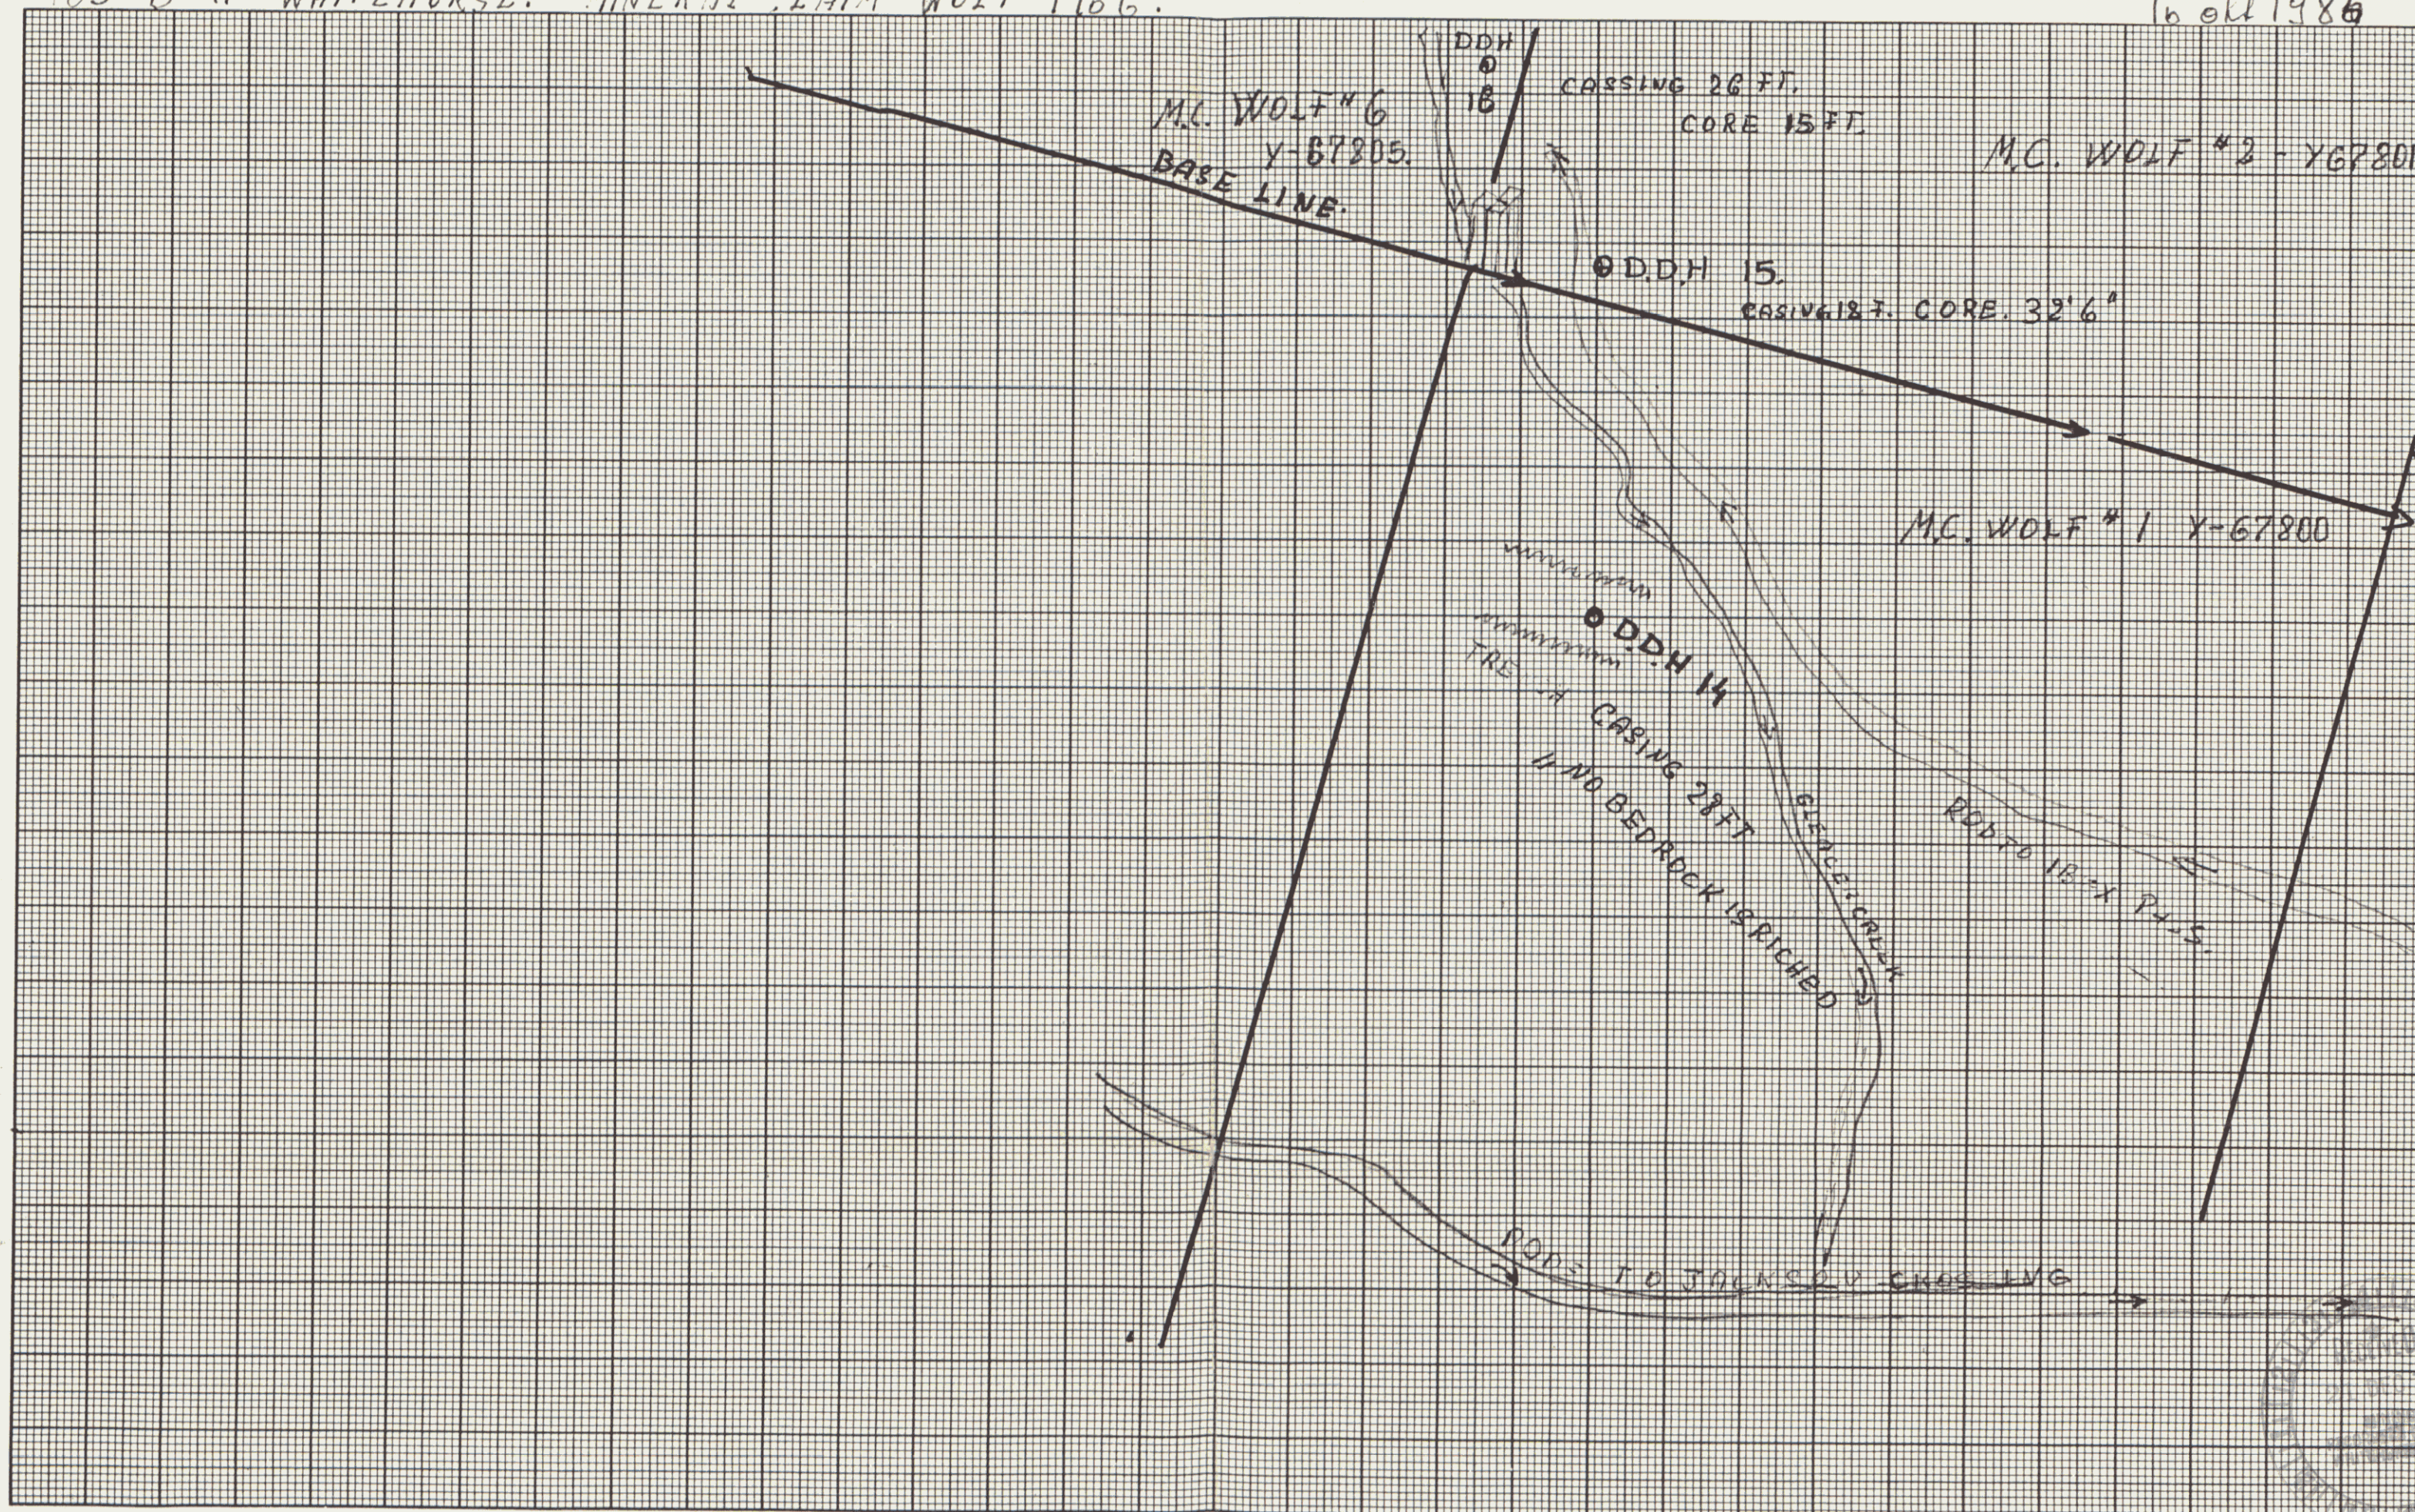


MINERAL CLAIM. WOLF. 105-D-11. WHITEHORSE. MAP AREA.


M.C. WOLF # 1 D.D.H. # 10.
Y-67805

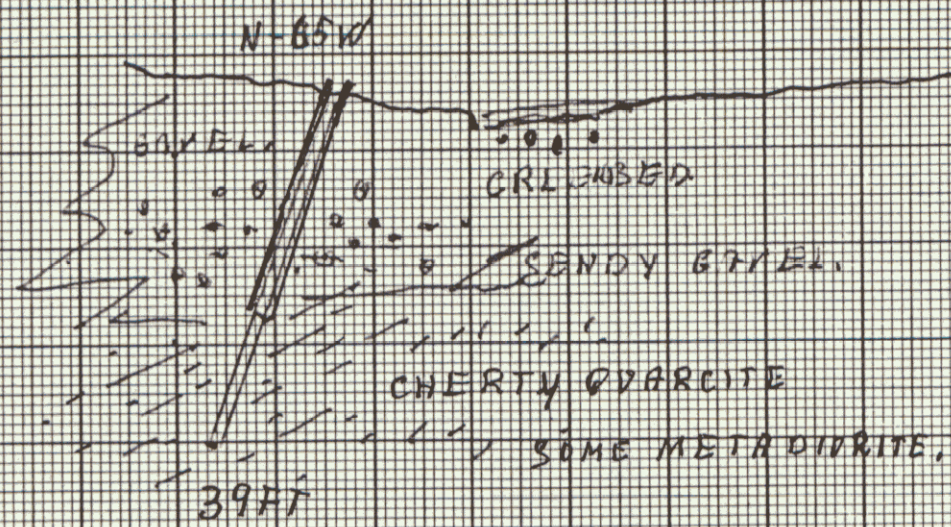

M.C. WOLF # 2 D.D.H. # 15.
67801

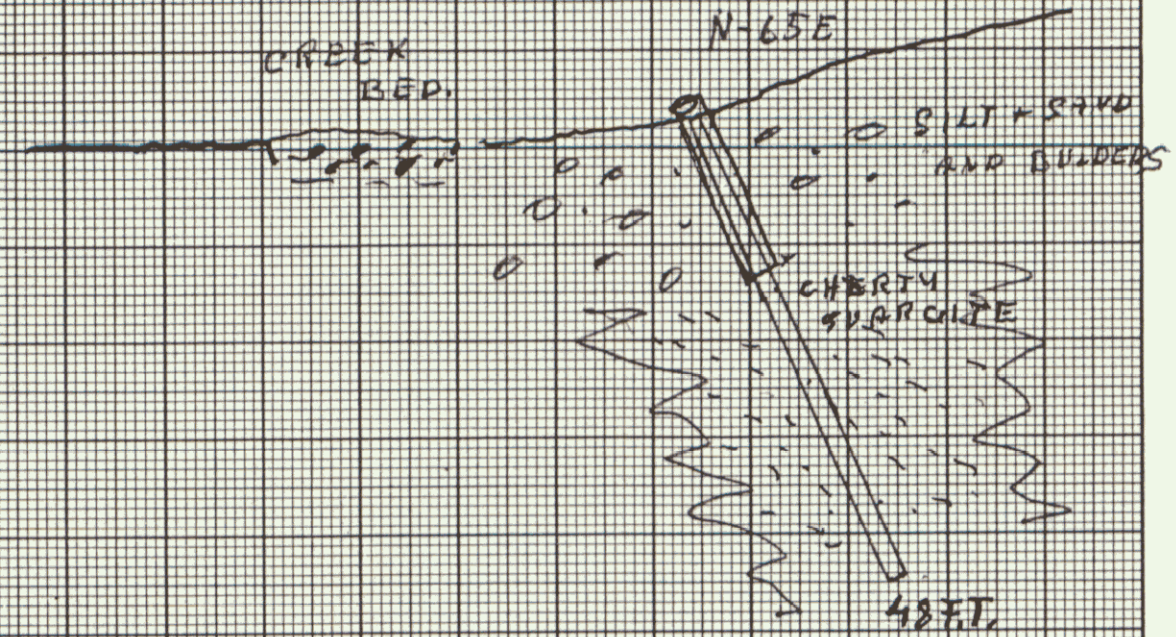

M.C. WOLF # 1 D.D.H. # 14
Y-67800.

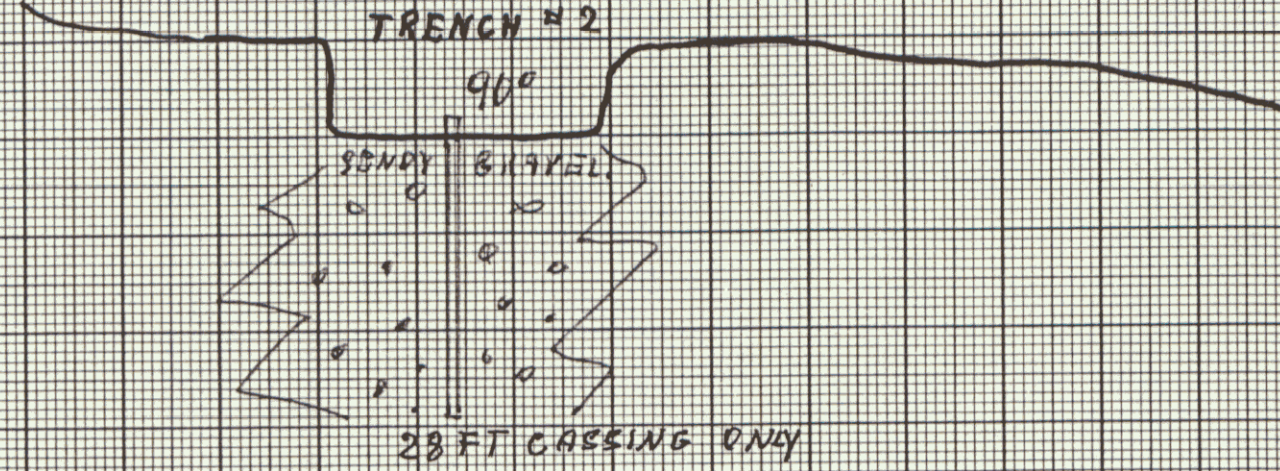

335-5016 20x20

SCALE 1/2" = 10 FT 16 OCT. 1984



091594 091594